







| SURVEYED          | DATE      | ISSUES | NO. | DATE       | DESCRIPTION    | CHECKED |
|-------------------|-----------|--------|-----|------------|----------------|---------|
| MA                | July 2026 |        | A   | 31.07.2026 | ORIGINAL ISSUE | TG      |
| LEVEL DATUM:      | AHD Der.  |        |     |            |                |         |
| ORIGIN OF LEVELS: | PM72575   |        |     |            |                |         |
| RL OF ORIGIN:     | 10.664    |        |     |            |                |         |
| CONTOUR INTERVAL: | -         |        |     |            |                |         |

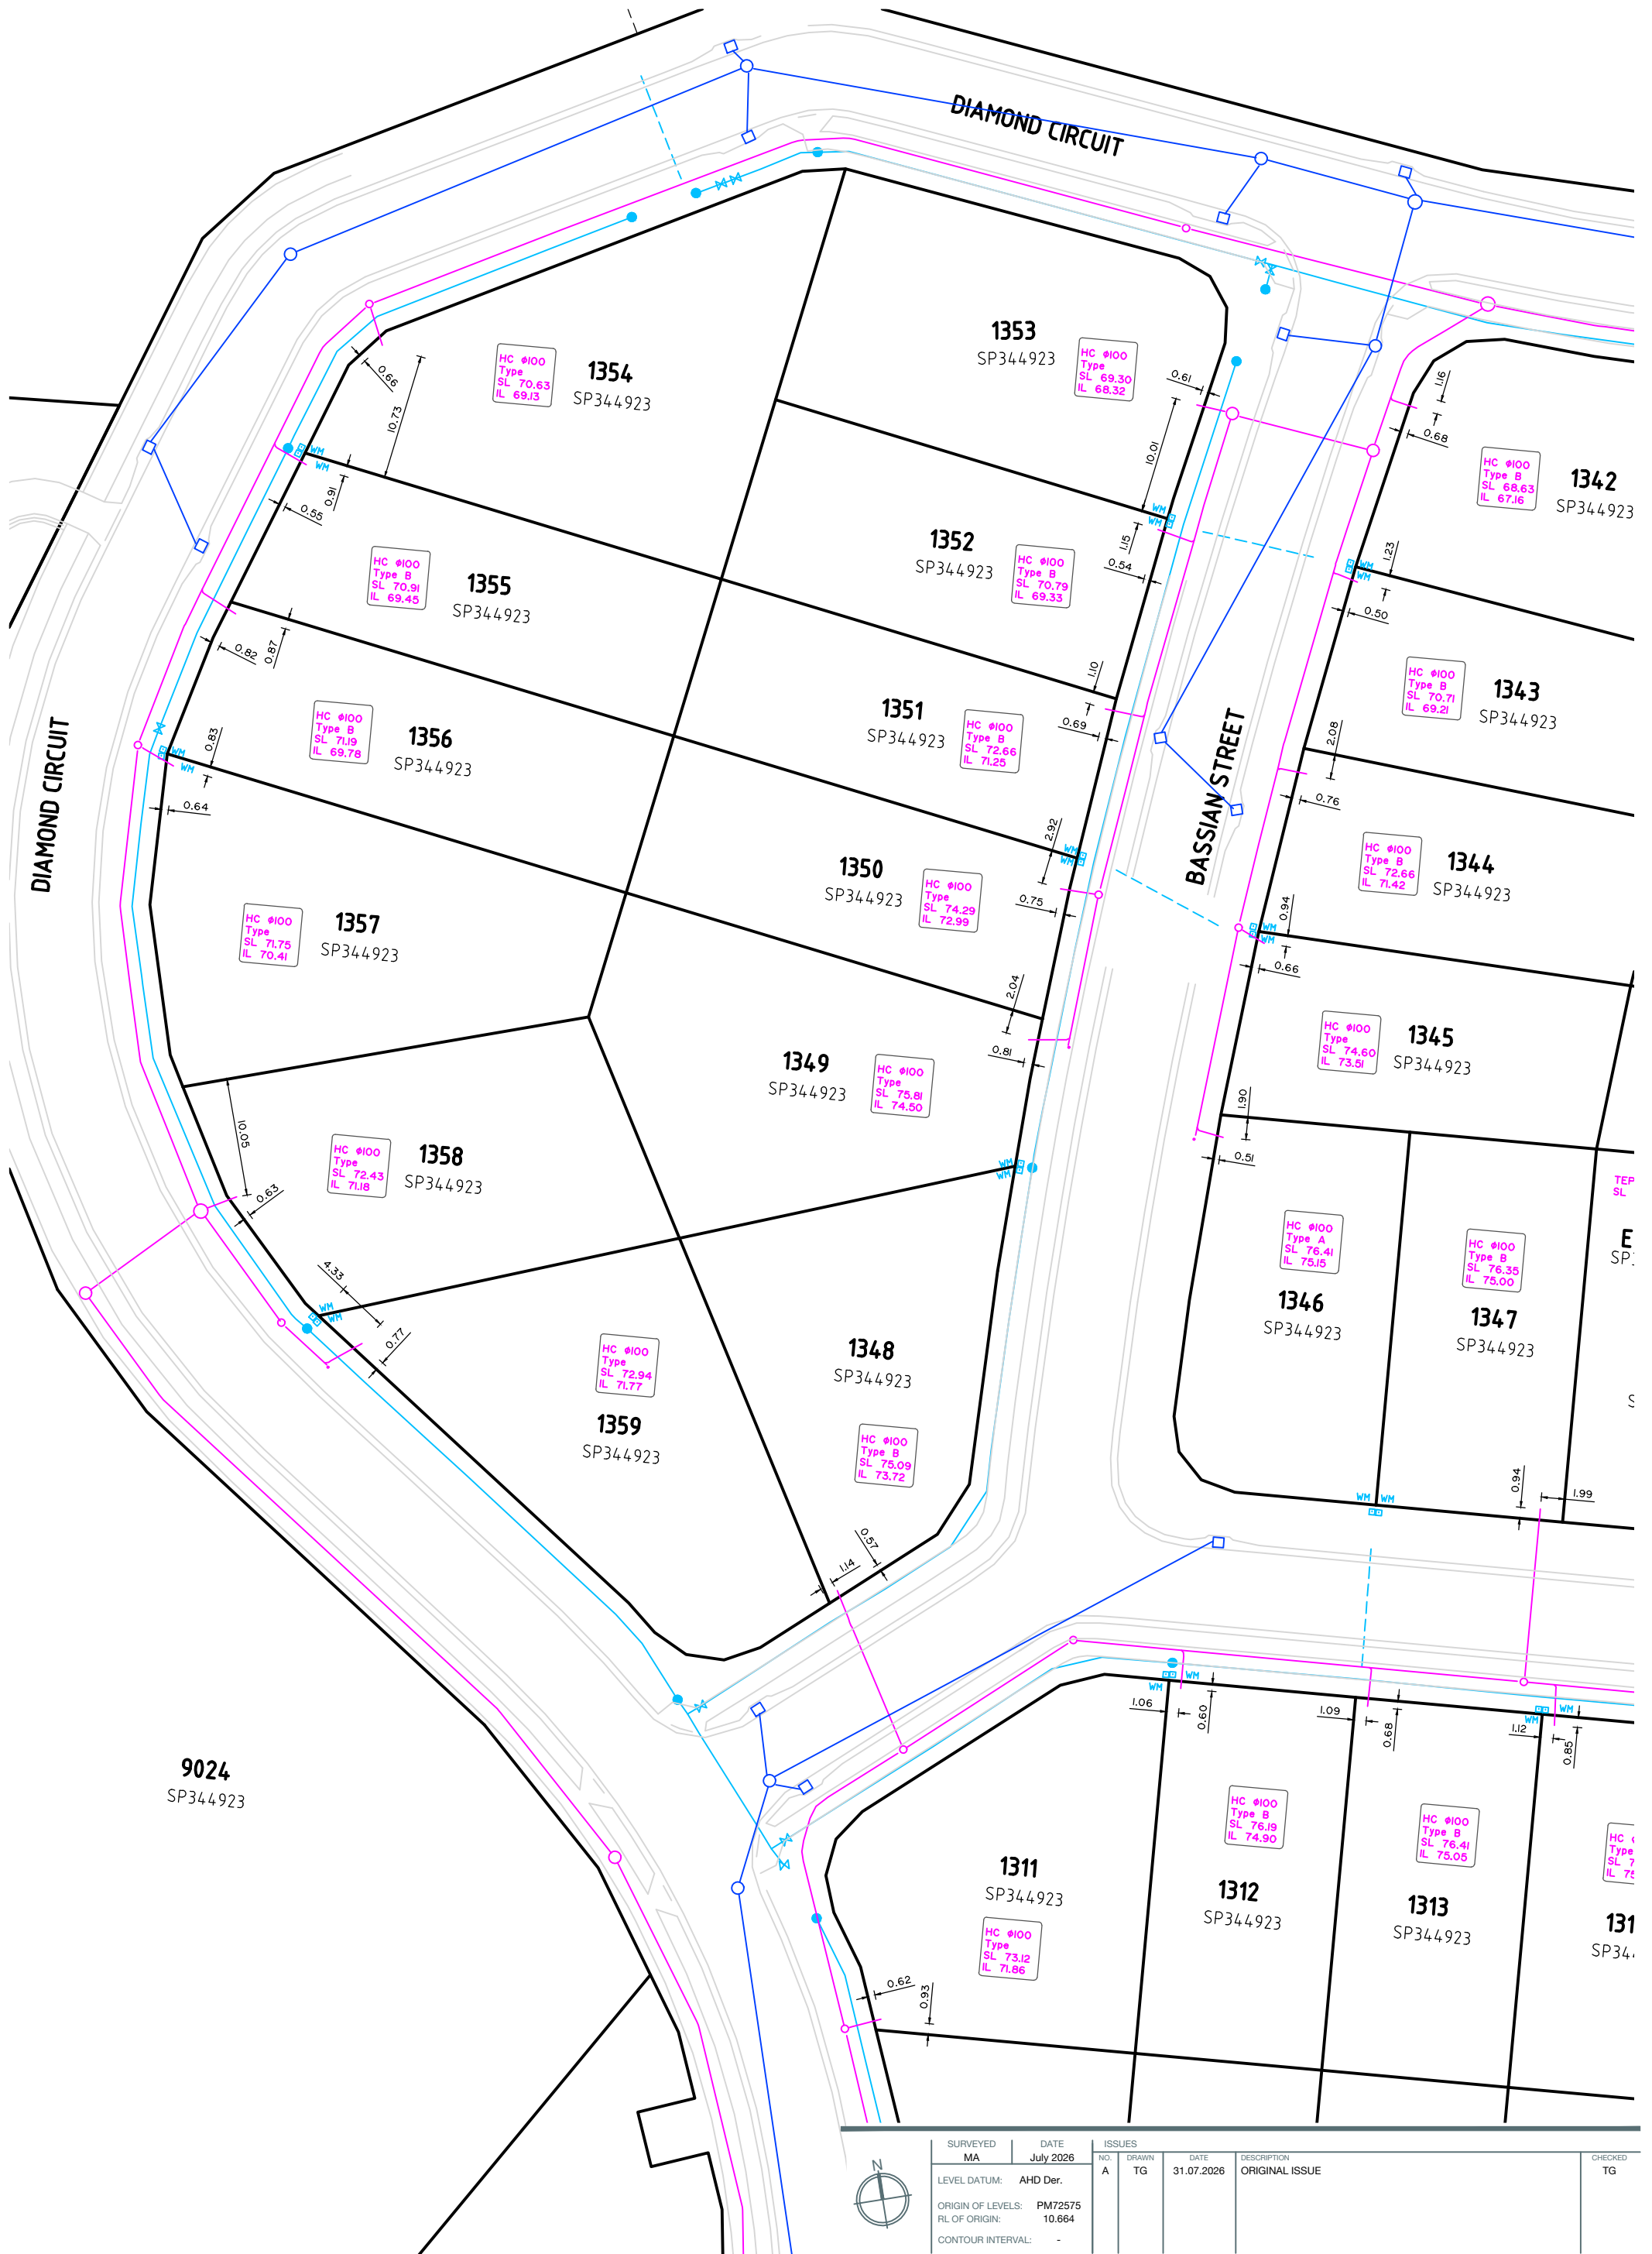

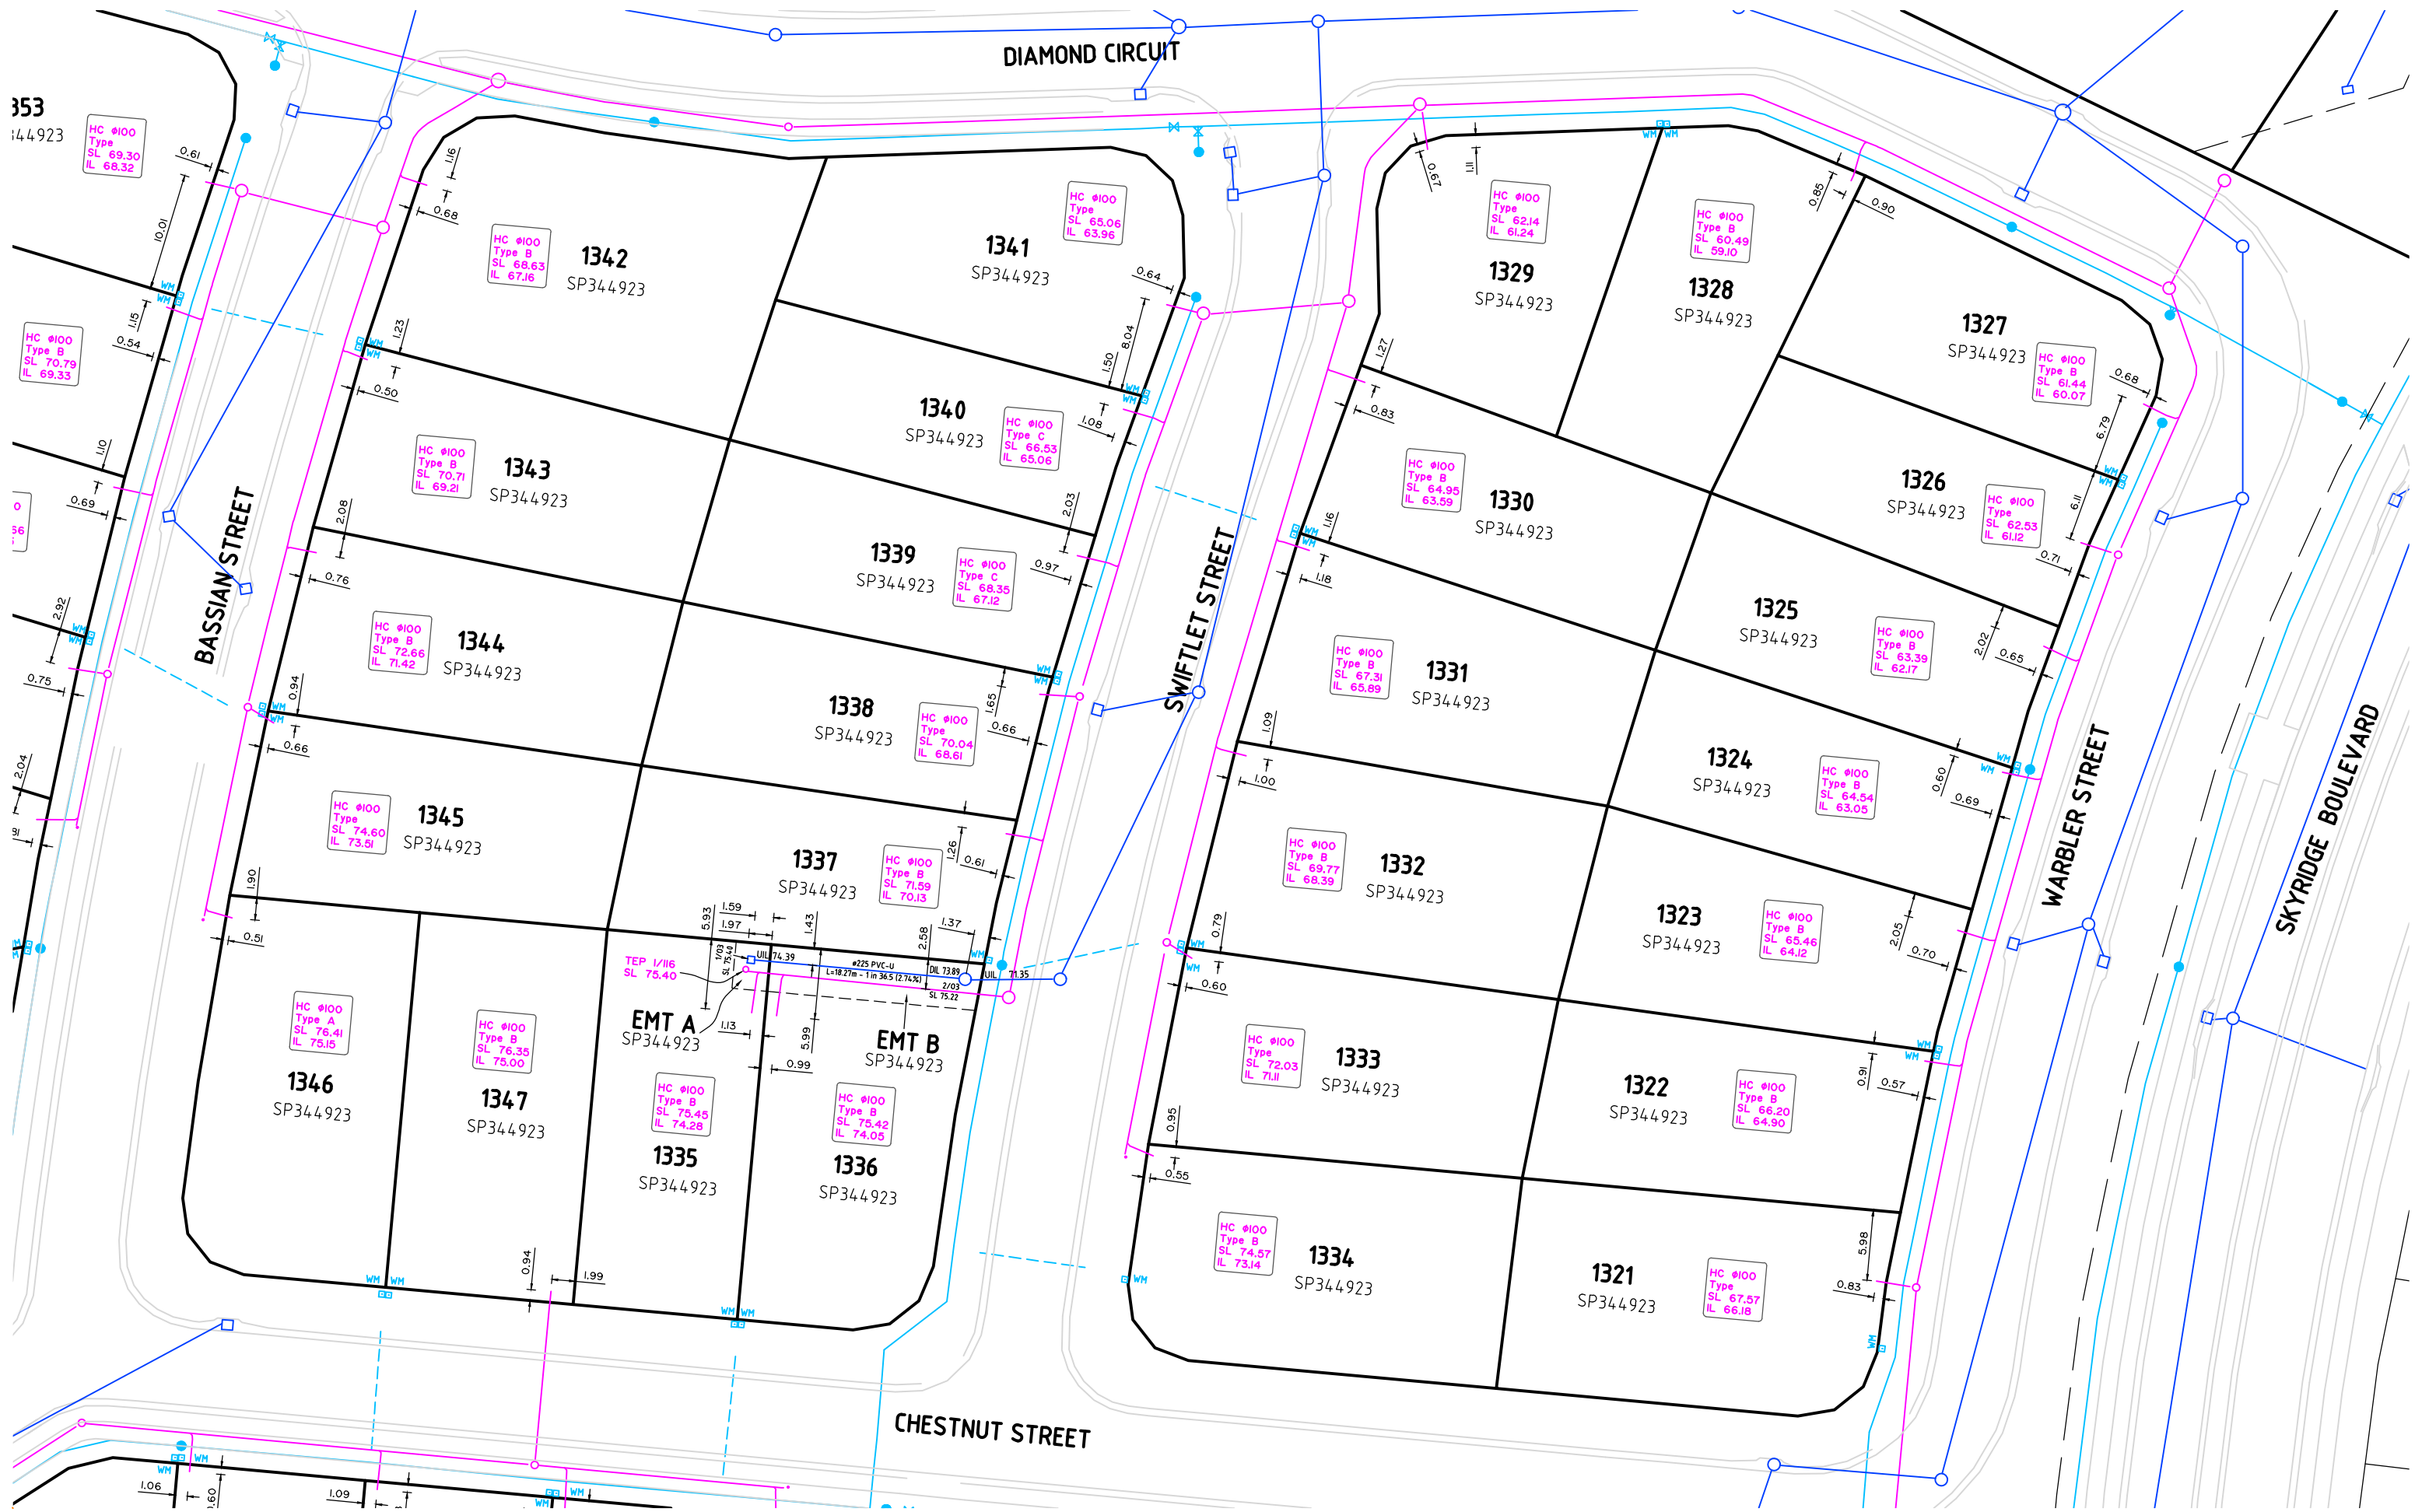

| ISSUES |             |            |                | CHECKED<br>TG |
|--------|-------------|------------|----------------|---------------|
| NO.    | DRAWN<br>TG | DATE       | DESCRIPTION    |               |
| A      |             | 31.07.2026 | ORIGINAL ISSUE |               |

| LOT DESCRIPTION                         |  |
|-----------------------------------------|--|
| LOTS 1301-1385 ON SP344923              |  |
| LOCALITY:<br>WORONGARY                  |  |
| LOCAL GOVERNMENT:<br>CITY OF GOLD COAST |  |

| SURVEYED<br>MA            | DATE<br>July 2026 |
|---------------------------|-------------------|
| LEVEL DATUM: AHD Der.     |                   |
| ORIGIN OF LEVELS: PM72575 |                   |
| RL OF ORIGIN: 10.664      |                   |
| CONTOUR INTERVAL: -       |                   |

| CLIENT                        |  |
|-------------------------------|--|
| FRASERS PROPERTY AUSTRALIA    |  |
| SCALE<br>1:250@A1<br>1:500@A3 |  |

| PROJECT             |  |
|---------------------|--|
| SKYRIDGE - STAGE 13 |  |

| DRAWING TITLE                                |  |
|----------------------------------------------|--|
| AS CONSTRUCTED SKETCH PLAN<br>(SHEET 3 OF 6) |  |
| DRAWING NO.                                  |  |
| 7737 S 119 AC A                              |  |





| ISSUES |             |            |                | CHECKED<br>TG |
|--------|-------------|------------|----------------|---------------|
| NO.    | DRAWN<br>TG | DATE       | DESCRIPTION    |               |
| A      |             | 31.07.2026 | ORIGINAL ISSUE |               |

| LOT DESCRIPTION                         |  |
|-----------------------------------------|--|
| LOTS 1301-1385 ON SP344923              |  |
| LOCALITY:<br>WORONGARY                  |  |
| LOCAL GOVERNMENT:<br>CITY OF GOLD COAST |  |


| SURVEYED<br>MA            | DATE<br>July 2026 |
|---------------------------|-------------------|
| LEVEL DATUM: AHD Der.     |                   |
| ORIGIN OF LEVELS: PM72575 |                   |
| RL OF ORIGIN: 10.664      |                   |
| CONTOUR INTERVAL: -       |                   |

| CLIENT                        |  |
|-------------------------------|--|
| FRASERS PROPERTY AUSTRALIA    |  |
| SCALE<br>1:250@A1<br>1:500@A3 |  |

| PROJECT             |  |
|---------------------|--|
| SKYRIDGE - STAGE 13 |  |


| DRAWING TITLE                                |                 |
|----------------------------------------------|-----------------|
| AS CONSTRUCTED SKETCH PLAN<br>(SHEET 4 OF 6) |                 |
| DRAWING NO.                                  | 7737 S 119 AC A |



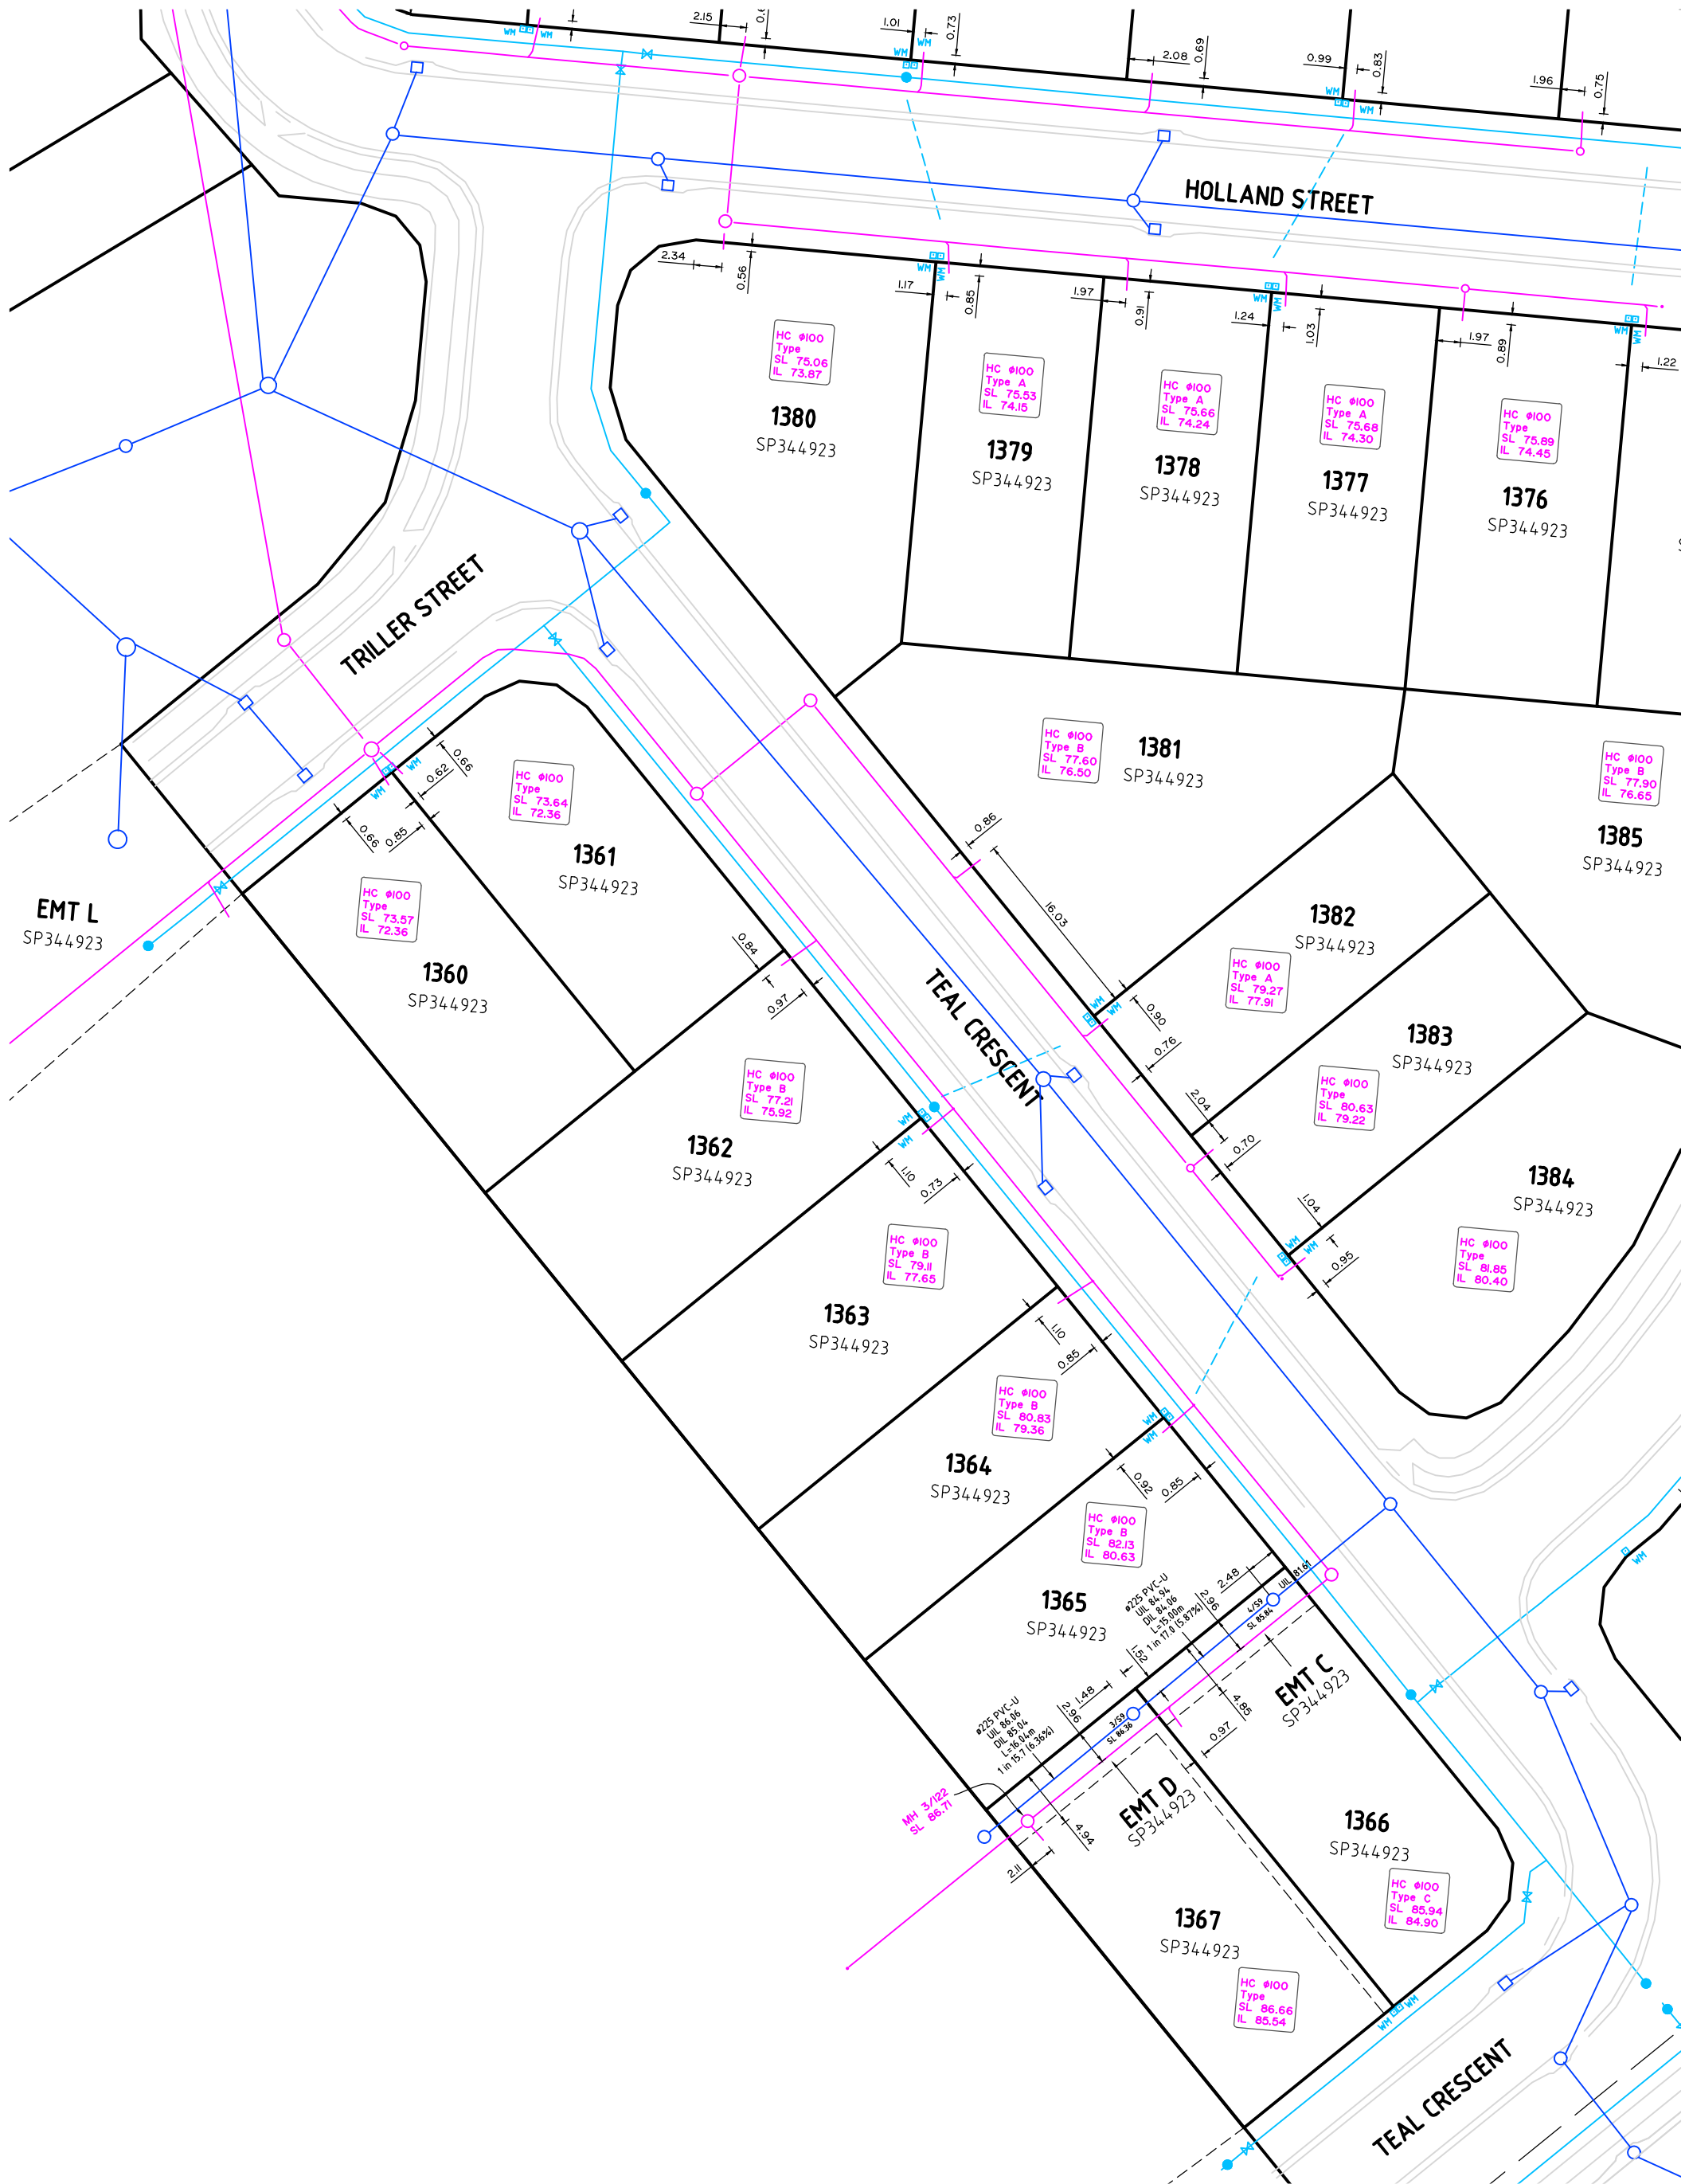

| SURVEYED          |  | DATE      |  | ISSUES |       | DESCRIPTION    | CHECKED |
|-------------------|--|-----------|--|--------|-------|----------------|---------|
| MA                |  | July 2026 |  | NO.    | DRAWN |                |         |
| LEVEL DATUM:      |  | AHD Der.  |  | A      | TG    |                |         |
| ORIGIN OF LEVELS: |  | PM72575   |  |        |       |                |         |
| RL OF ORIGIN:     |  | 10.664    |  |        |       | ORIGINAL ISSUE |         |
| CONTOUR INTERVAL: |  | -         |  |        |       |                |         |



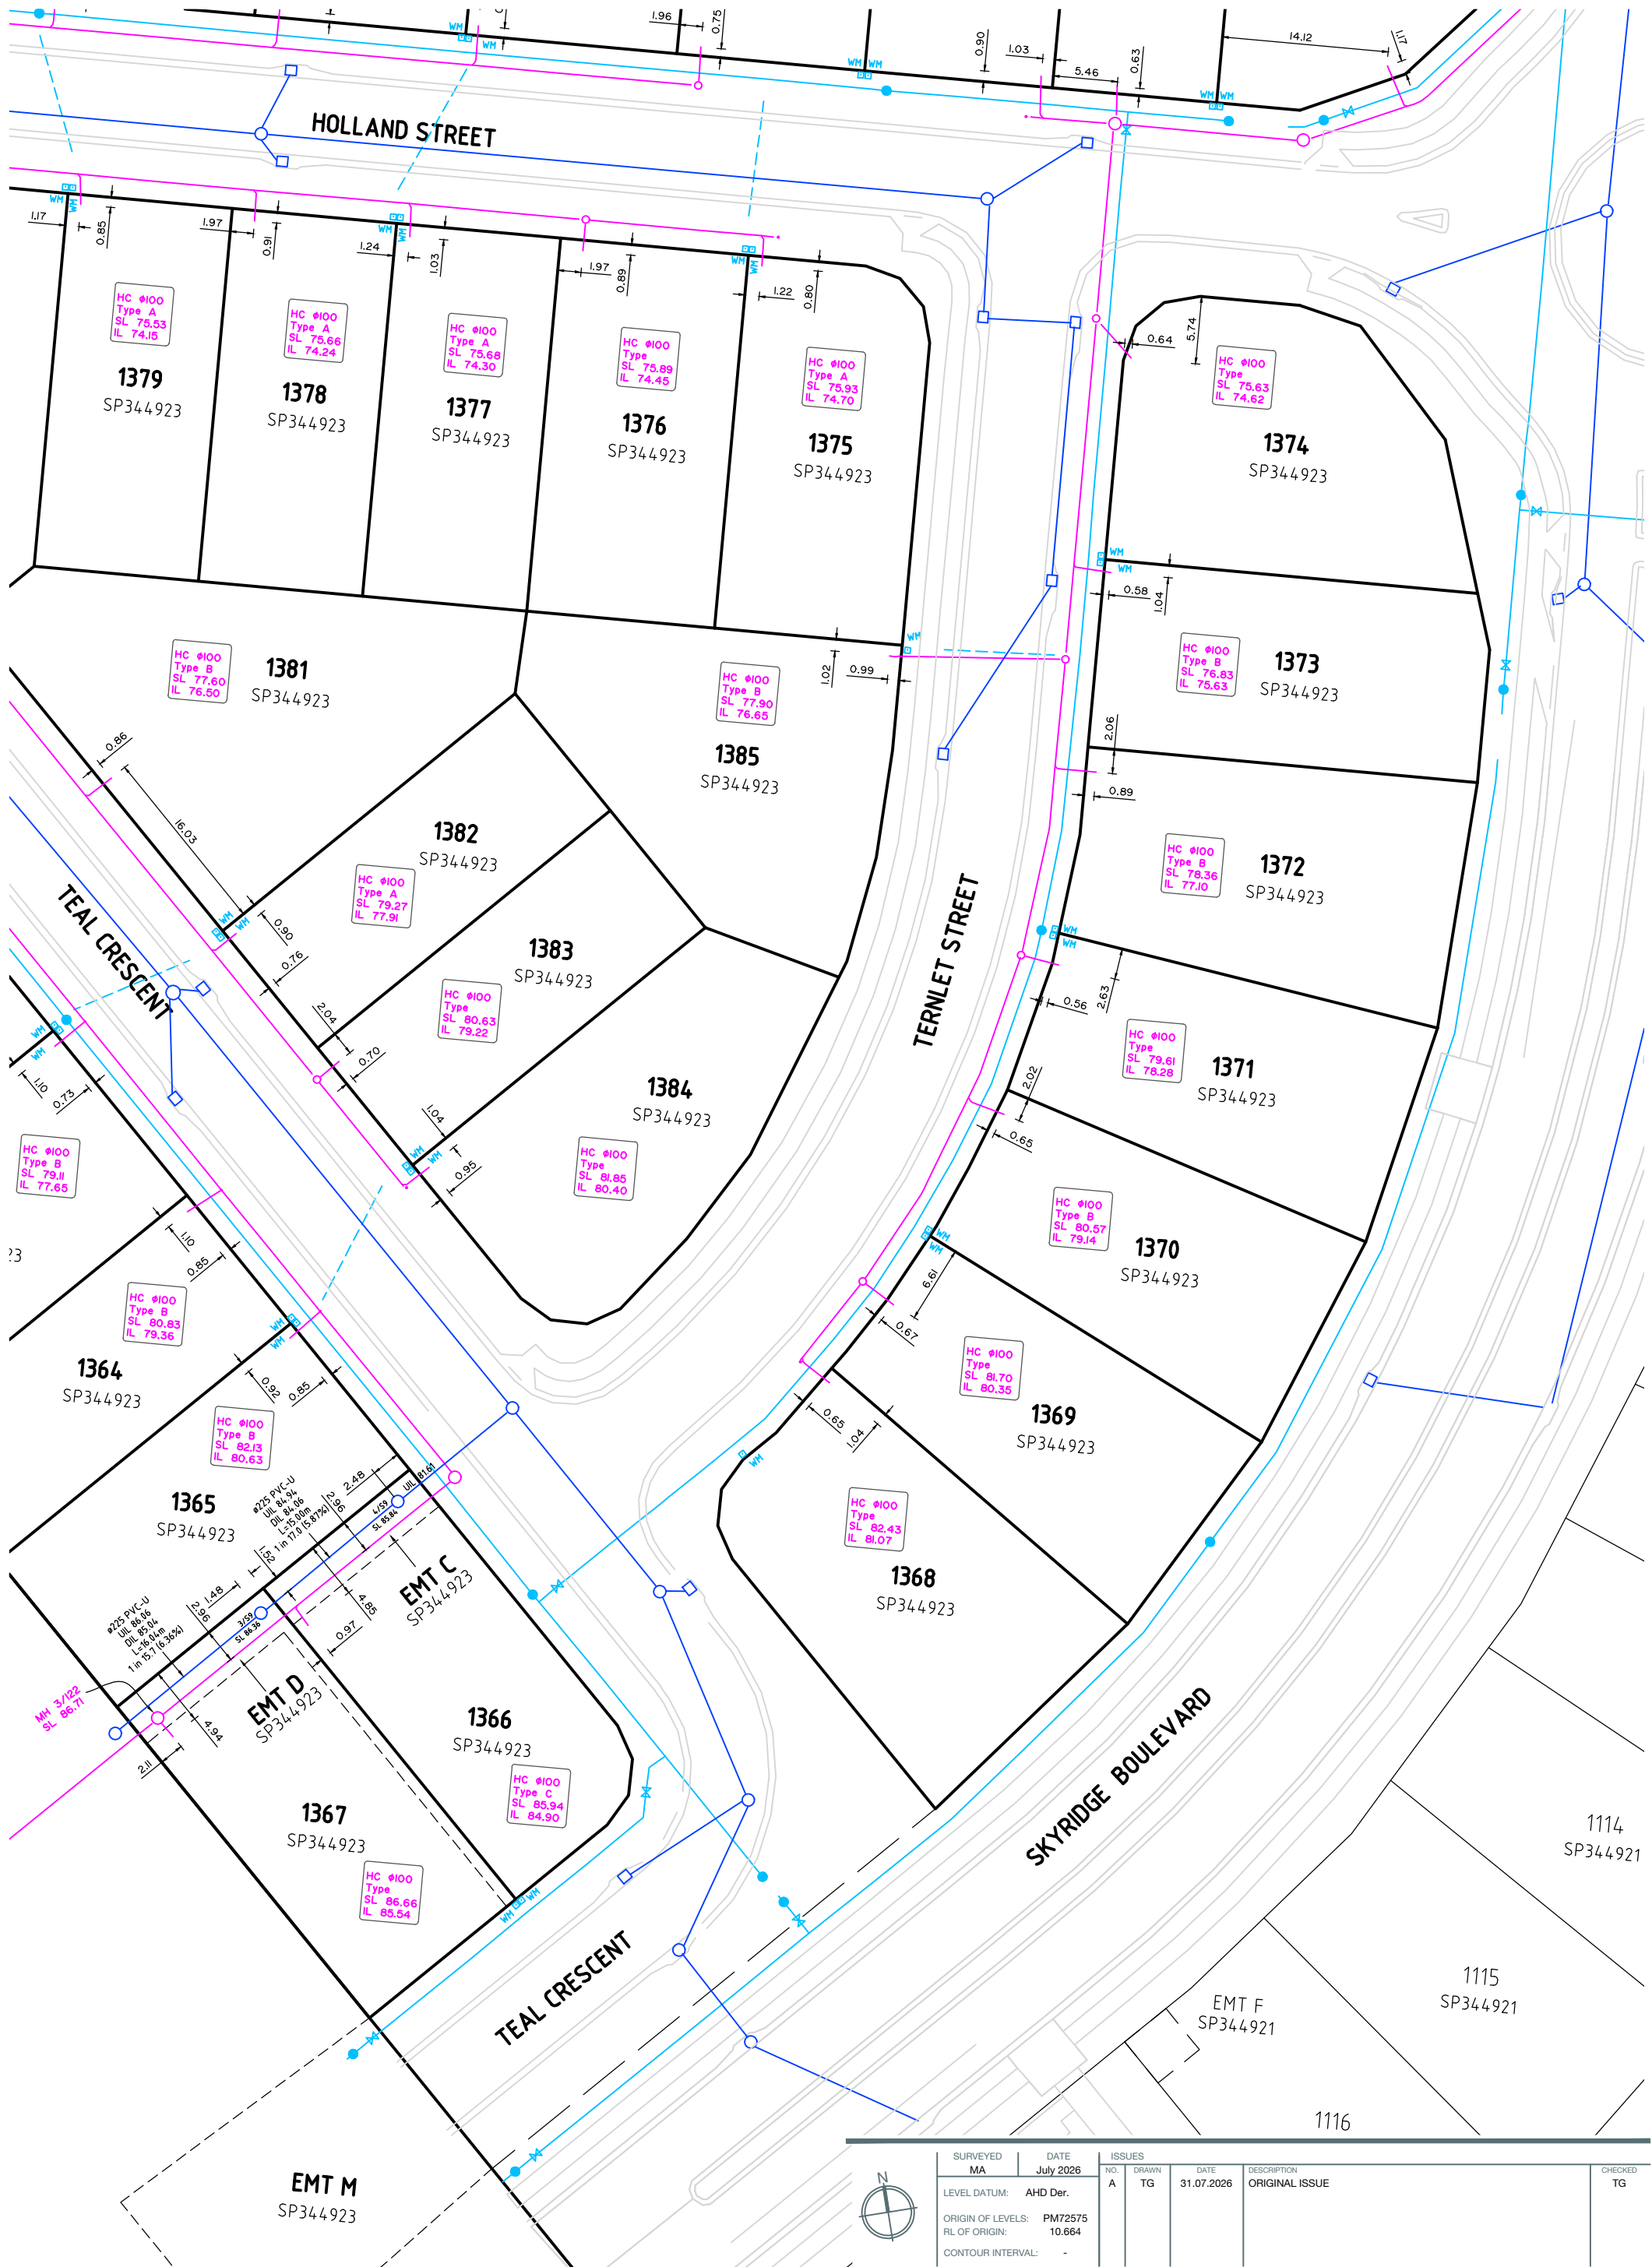



|                                                                          |                   |          |             |                    |                               |               |
|--------------------------------------------------------------------------|-------------------|----------|-------------|--------------------|-------------------------------|---------------|
| SURVEYED<br>MA                                                           | DATE<br>July 2026 | ISSUES   |             |                    |                               | CHECKED<br>TG |
|                                                                          |                   | NO.<br>A | DRAWN<br>TG | DATE<br>31.07.2026 | DESCRIPTION<br>ORIGINAL ISSUE |               |
| LEVEL DATUM: AHD Der.                                                    |                   |          |             |                    |                               |               |
| ORIGIN OF LEVELS: PM72575<br>RL OF ORIGIN: 10.664<br>CONTOUR INTERVAL: - |                   |          |             |                    |                               |               |

