

NOTES

This plan has been prepared from as-constructed survey of sewerage, water & drainage services only.

Before starting any demolition, excavation or construction on the site, the relevant person should make an independent and updated enquiry of "dial before you dig" and any relevant service providers to ascertain the existence of further services (if any) and the accurate location of those not able to have been surveyed at the time of preparing this plan.

This plan has been prepared for information purposes only and is subject to final approval & acceptance by City of Gold Coast

* No responsibility can be accepted by Saunders Havill Group Pty Ltd, for any damage caused to any underground service or any loss or injury so suffered if enquiry and verification have not been completed in accordance with this note.

** This note is an integral part of this plan/data. Reproduction of this plan or any part of it without this note being included in full will render the information shown on such reproduction invalid and not suitable for use.

SYMBOLS		ABBREVIATIONS		LEGEND	
Sewer Manhole / Shaft	by Survey	MH	Manhole	SEWER MAINS	by Survey
Fire Hydrant Valve	●	MS	Maintenance Shaft	WATER SUPPLY	—
Water Meter	⊗	SL	Surface Level	WATER CONDUIT	- - -
Stormwater Manhole	⊗ WM	IL	Invert Level	STORMWATER	—
Stormwater Pit	○	BM	Bench Mark		
Roofwater Pit	□	Ø	Diameter		
		HC	House Connection		
		TEP	Terminal Entry Point		

	SURVEYED	DATE	ISSUES	NO. DRAWN DATE DESCRIPTION A B TG TG 11.12.2025 ORIGINAL ISSUE 25.02.2026 DRAINAGE ADDED	CHECKED TG TG
	MA	Oct-Nov, 2025			
	LEVEL DATUM:	AHD Der.			
	ORIGIN OF LEVELS:	PM72575			
	RL OF ORIGIN:	10.664			
	CONTOUR INTERVAL:	-			

NOTES


This plan has been prepared from as-constructed survey of sewerage, water & drainage services only.

Before starting any demolition, excavation or construction on the site, the relevant person should make an independent and updated enquiry of "dial before you dig" and any relevant service providers to ascertain the existence of further services (if any) and the accurate location of those not able to have been surveyed at the time of preparing this plan.

This plan has been prepared for information purposes only and is subject to final approval & acceptance by City of Gold Coast

* No responsibility can be accepted by Saunders Havill Group Pty Ltd, for any damage caused to any underground service or any loss or injury so suffered if enquiry and verification have not been completed in accordance with this note.

** This note is an integral part of this plan/data. Reproduction of this plan or any part of it without this note being included in full will render the information shown on such reproduction invalid and not suitable for use.

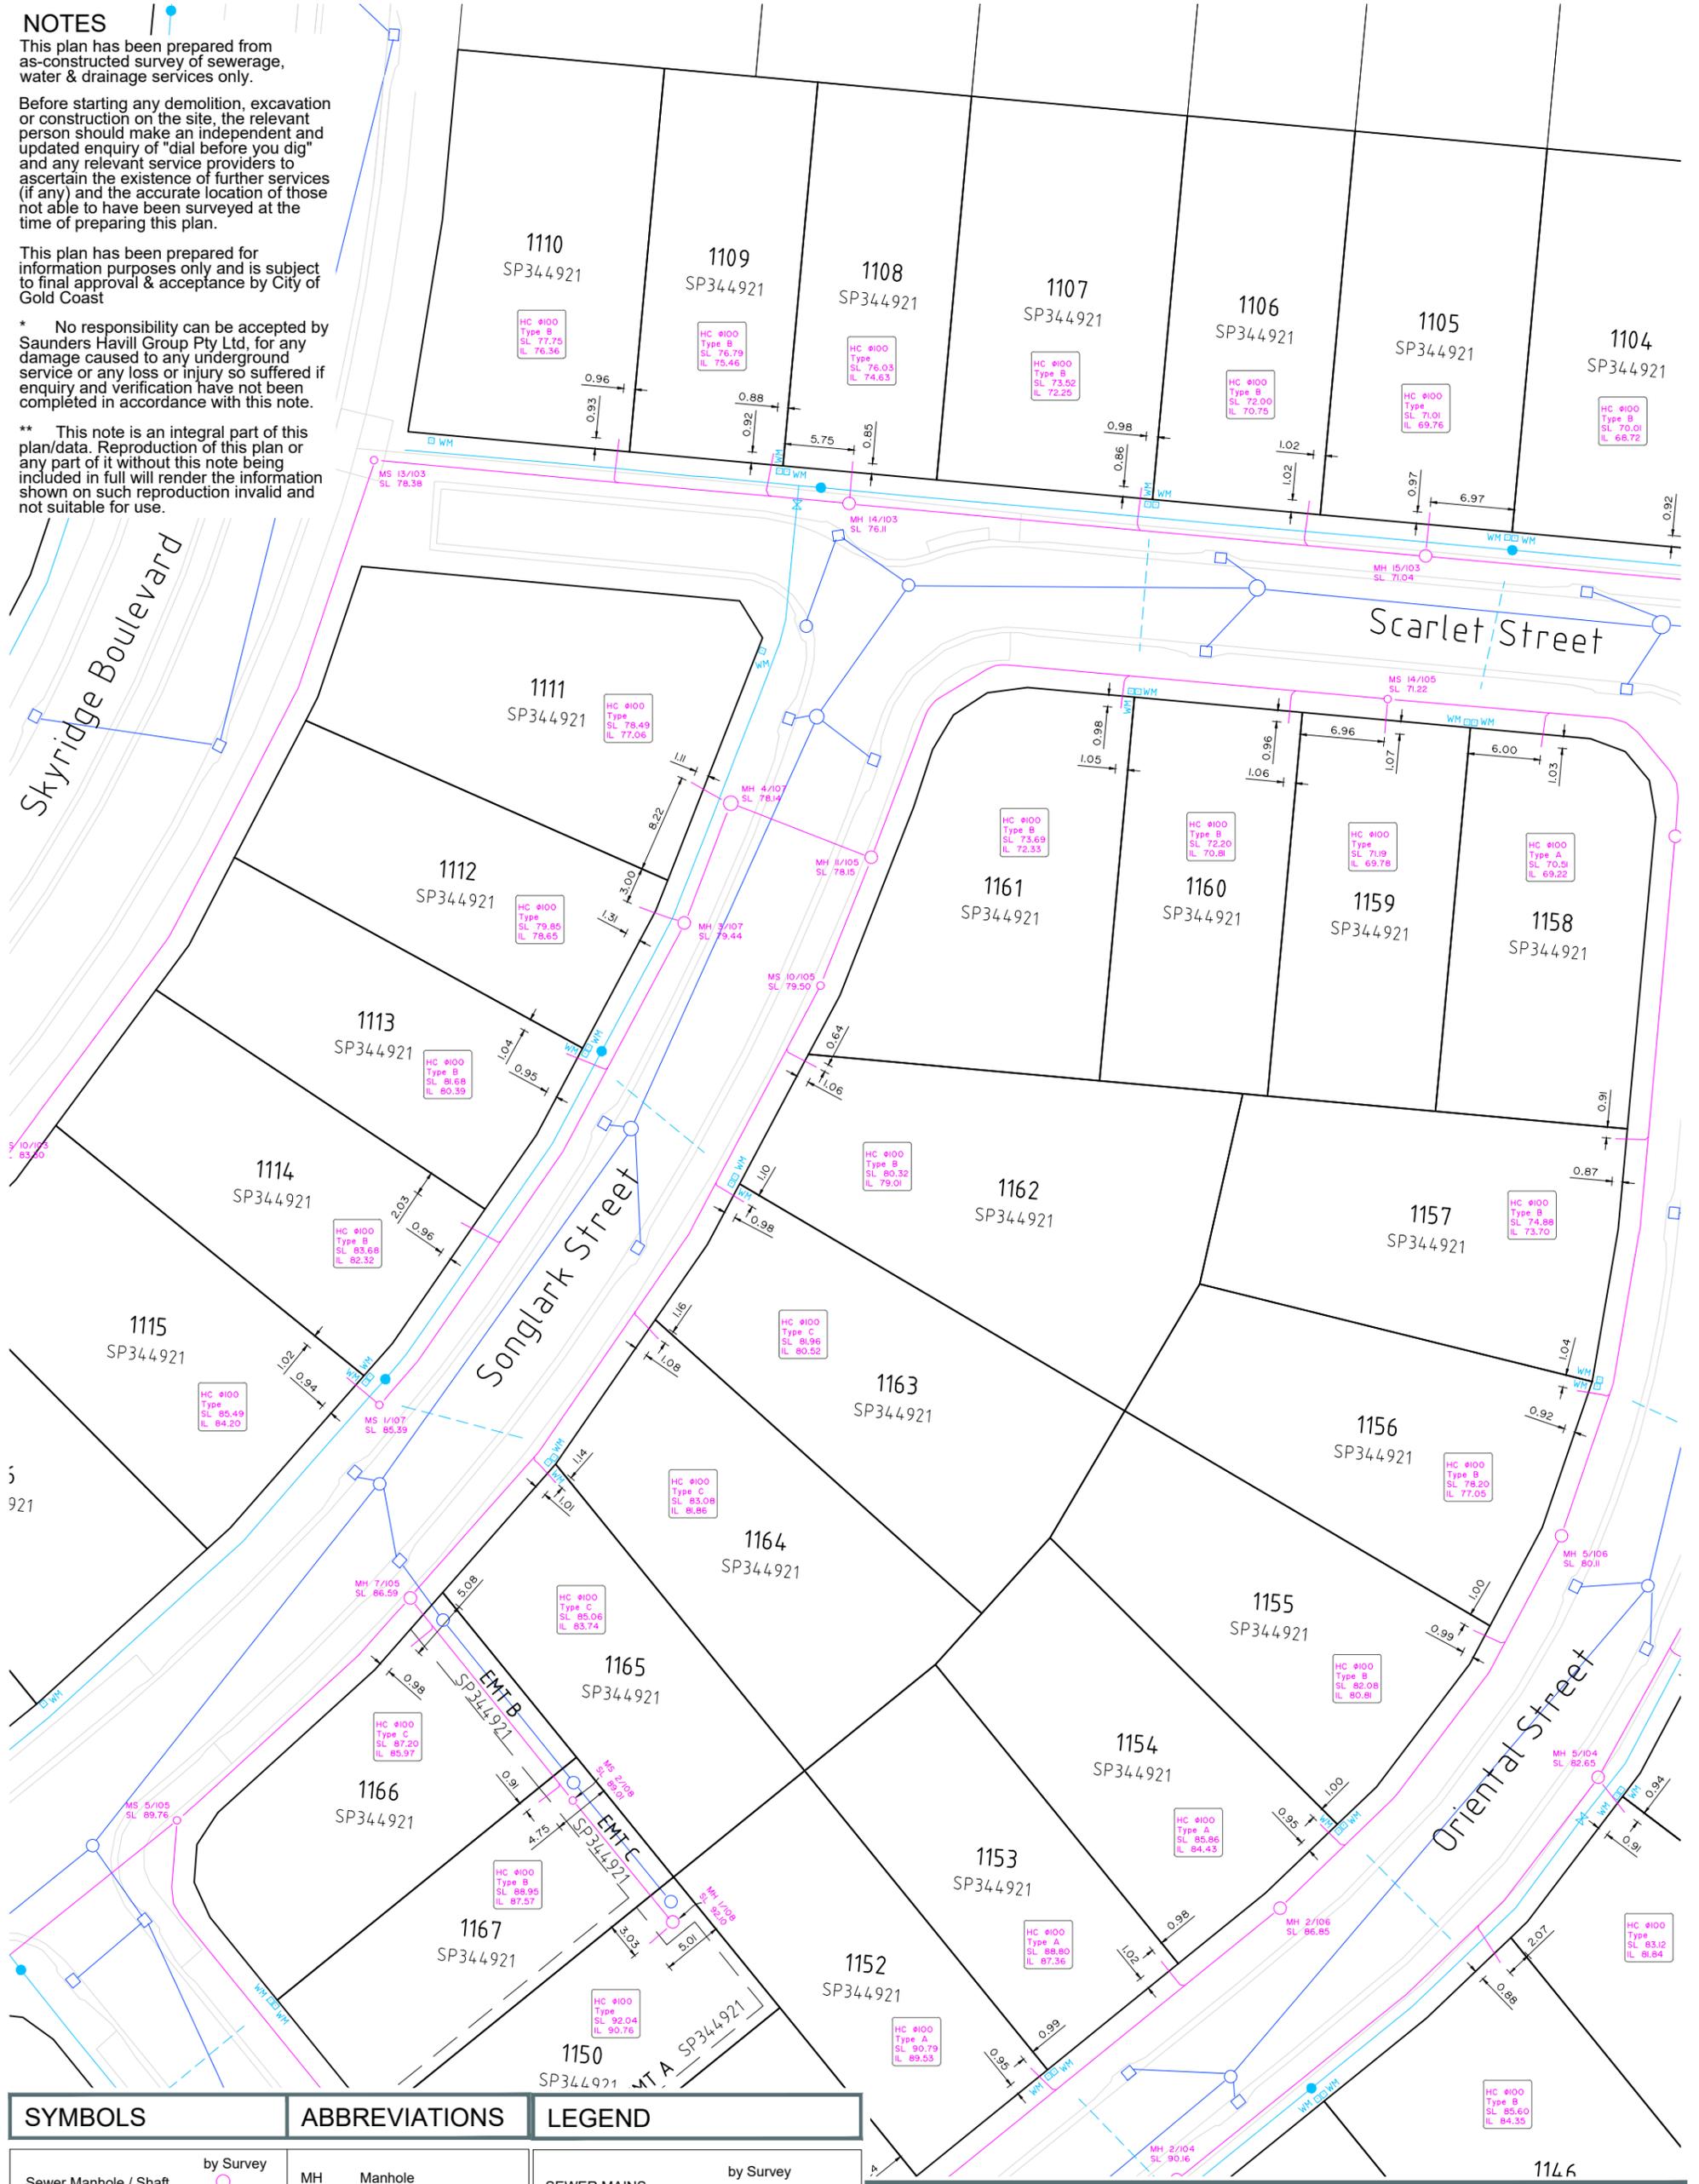

SYMBOLS

Sewer Manhole / Shaft	by Survey	MH	Manhole
Fire Hydrant	●	MS	Maintenance Shaft
Valve	●	SL	Surface Level
Water Meter	□ WM	IL	Invert Level
Stormwater Manhole	○	BM	Bench Mark
Stormwater Pit	□	Ø	Diameter
Roofwater Pit	□/○	HC	House Connection
		TEP	Terminal Entry Point


ABBREVIATIONS

MH	Manhole
MS	Maintenance Shaft
SL	Surface Level
IL	Invert Level
BM	Bench Mark
Ø	Diameter
HC	House Connection
TEP	Terminal Entry Point

LEGEND

SEWER MAINS	by Survey
WATER SUPPLY	—
WATER CONDUIT	- - -
STORMWATER	—

SURVEYED	DATE	ISSUES	NO.	DRAWN	DATE	DESCRIPTION	CHECKED
MA	Oct-Nov, 2025	A	TG	11.12.2025	ORIGINAL ISSUE		TG
LEVEL DATUM:	AHD Der.	B	TG	25.02.2026	DRAINAGE ADDED		TG
ORIGIN OF LEVELS:	PM72575						
RL OF ORIGIN:	10.664						
CONTOUR INTERVAL:	-						

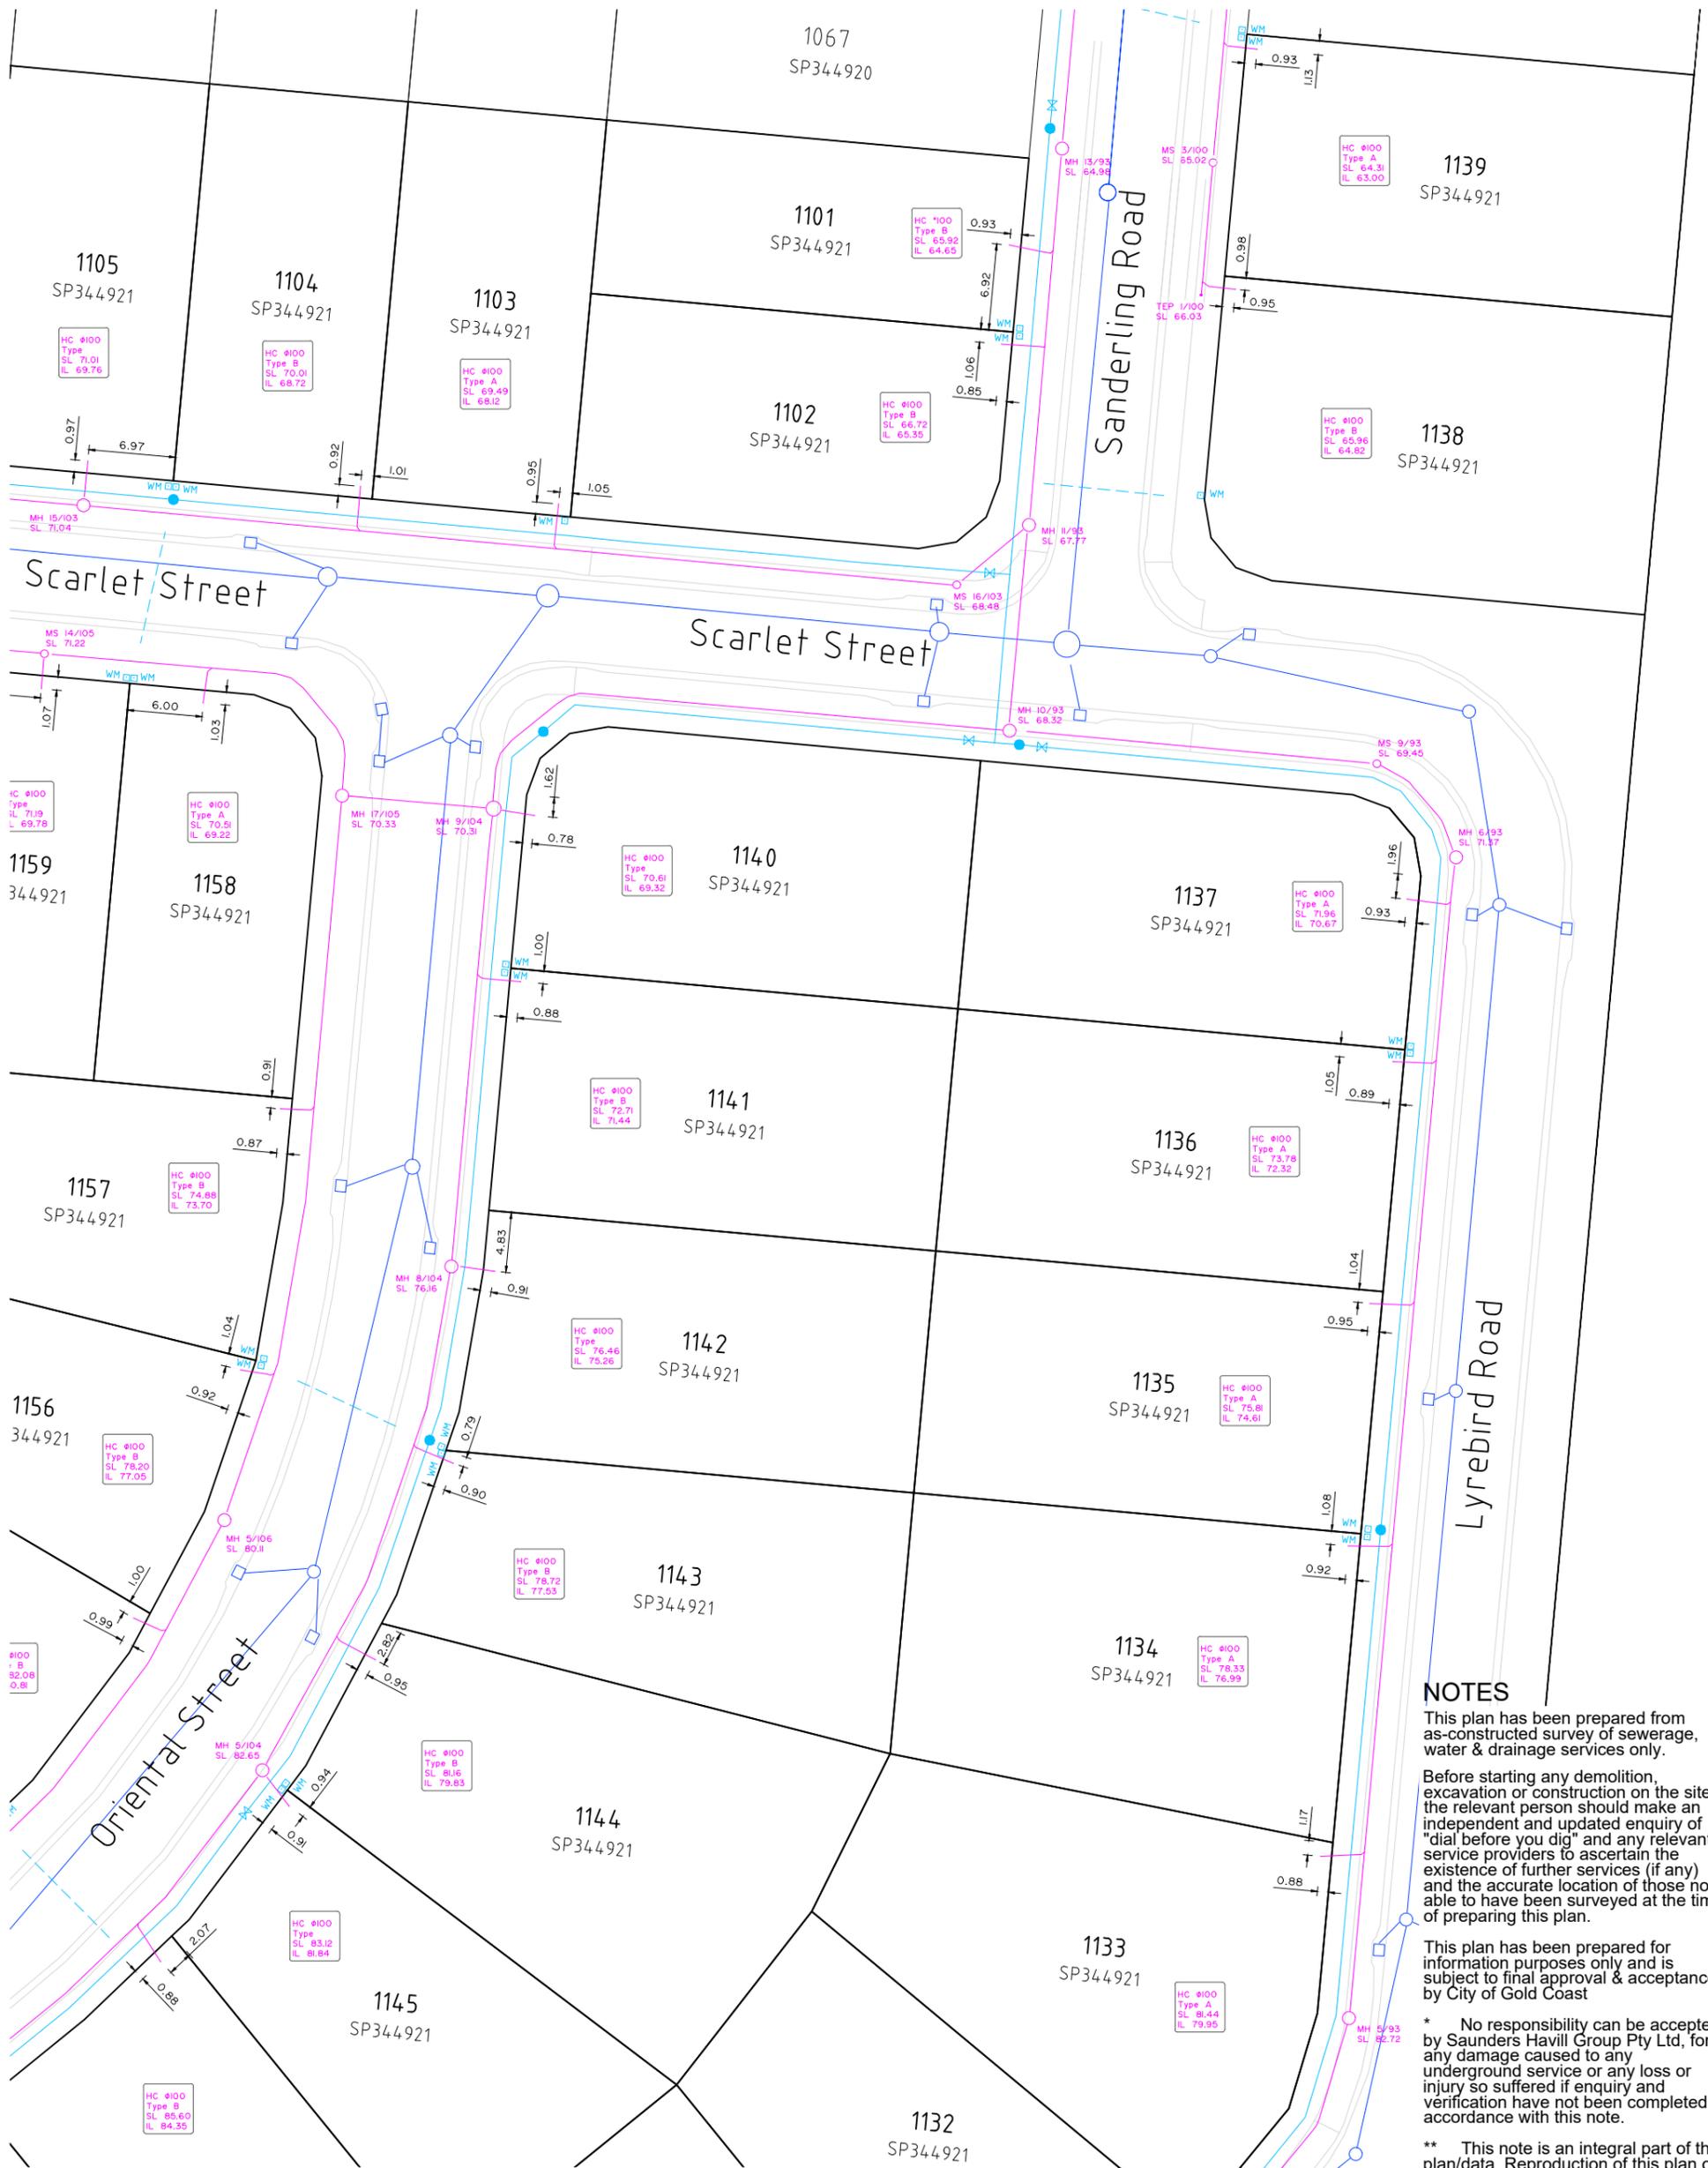

NOTES

This plan has been prepared from as-constructed survey of sewerage, water & drainage services only.

Before starting any demolition, excavation or construction on the site, the relevant person should make an independent and updated enquiry of "dial before you dig" and any relevant service providers to ascertain the existence of further services (if any) and the accurate location of those not able to have been surveyed at the time of preparing this plan.


This plan has been prepared for information purposes only and is subject to final approval & acceptance by City of Gold Coast

* No responsibility can be accepted by Saunders Havill Group Pty Ltd, for any damage caused to any underground service or any loss or injury so suffered if enquiry and verification have not been completed in accordance with this note.

** This note is an integral part of this plan/data. Reproduction of this plan or any part of it without this note being included in full will render the information shown on such reproduction invalid and not suitable for use.

SYMBOLS		ABBREVIATIONS		LEGEND	
Sewer Manhole / Shaft	by Survey	MH	Manhole	SEWER MAINS	by Survey
Fire Hydrant	●	MS	Maintenance Shaft	WATER SUPPLY	—
Valve	●	SL	Surface Level	WATER CONDUIT	- - - -
Water Meter	⊠	IL	Invert Level	STORMWATER	—
Stormwater Manhole	⊠	BM	Bench Mark		
Stormwater Pit	⊠	Ø	Diameter		
Roofwater Pit	⊠	HC	House Connection		
		TEP	Terminal Entry Point		

	SURVEYED	DATE	ISSUES	DESCRIPTION ORIGINAL ISSUE DRAINAGE ADDED	CHECKED TG TG
	MA	Oct-Nov, 2025	NO. A		
	LEVEL DATUM:	AHD Der.	NO. A	DATE	
	ORIGIN OF LEVELS:	PM72575	NO. B	11.12.2025	
	RL OF ORIGIN:	10.664		25.02.2026	
	CONTOUR INTERVAL:	-			

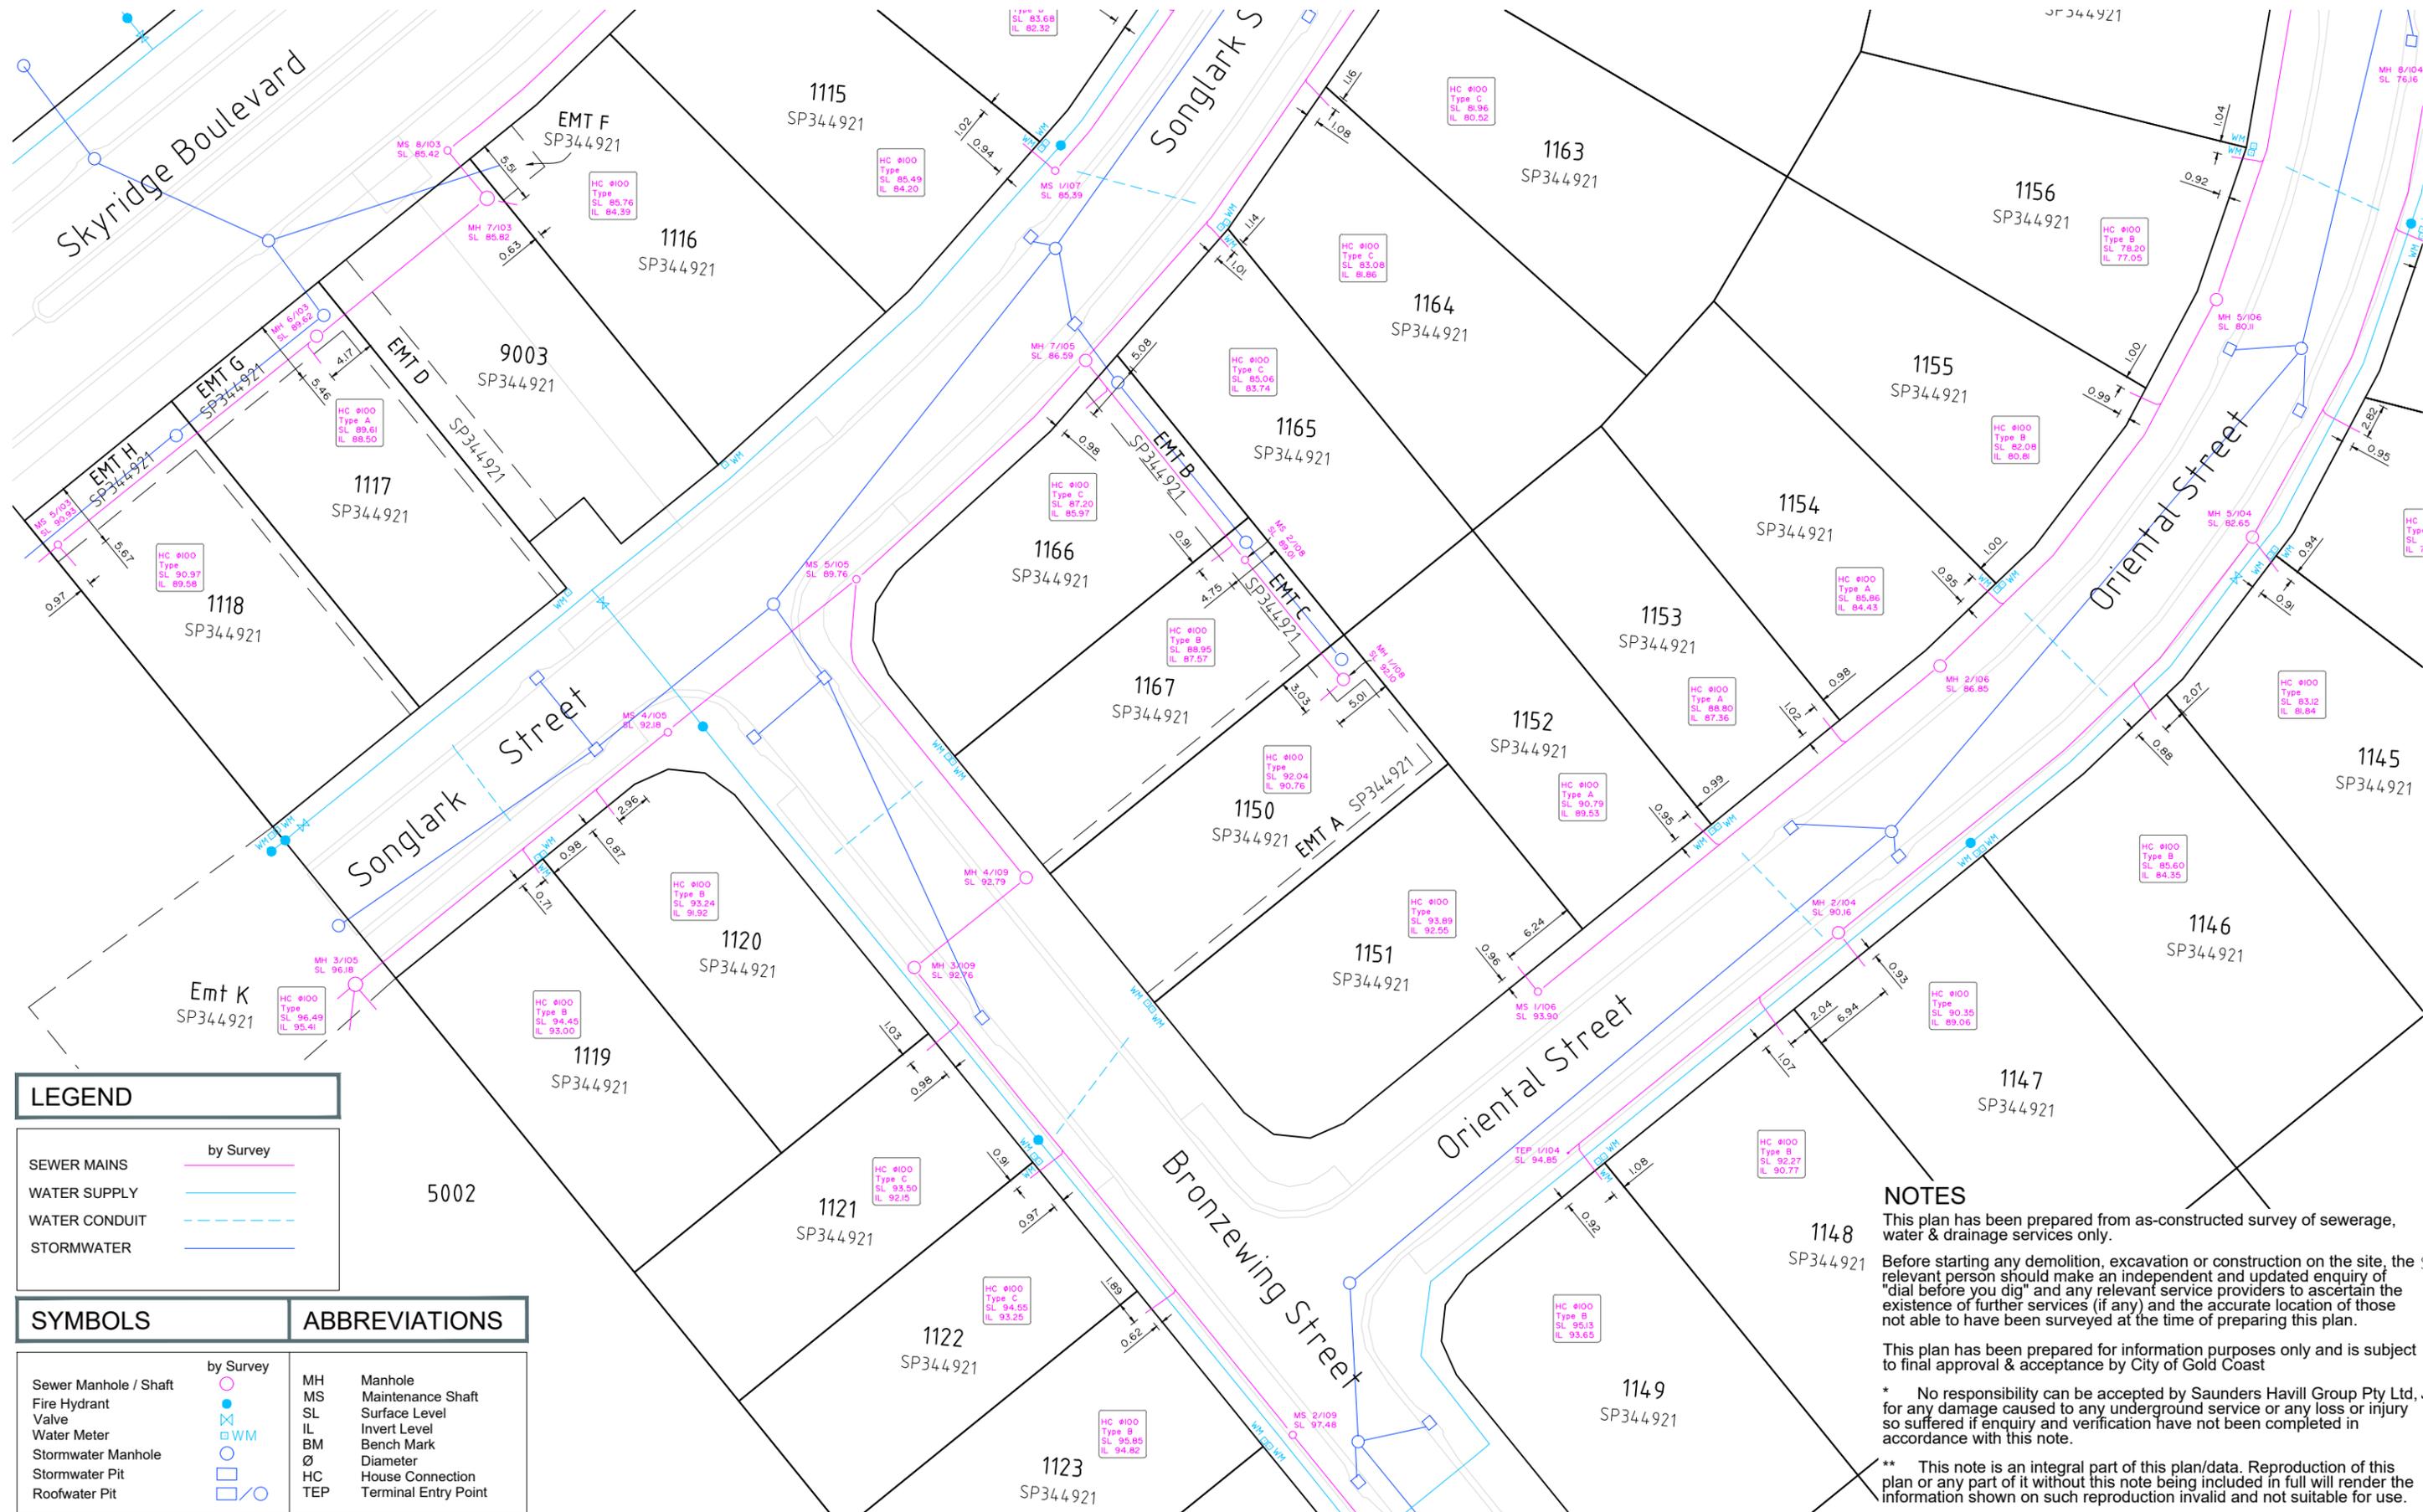

LEGEND

	by Survey
SEWER MAINS	
WATER SUPPLY	
WATER CONDUIT	
STORMWATER	

SYMBOLS

	by Survey
Sewer Manhole / Shaft	
Fire Hydrant	
Valve	
Water Meter	
Stormwater Manhole	
Stormwater Pit	
Roofwater Pit	

ABBREVIATIONS

MH	Manhole
MS	Maintenance Shaft
SL	Surface Level
IL	Invert Level
BM	Bench Mark
Ø	Diameter
HC	House Connection
TEP	Terminal Entry Point

NOTES

This plan has been prepared from as-constructed survey of sewerage, water & drainage services only.

Before starting any demolition, excavation or construction on the site, the relevant person should make an independent and updated enquiry of "dial before you dig" and any relevant service providers to ascertain the existence of further services (if any) and the accurate location of those not able to have been surveyed at the time of preparing this plan.

This plan has been prepared for information purposes only and is subject to final approval & acceptance by City of Gold Coast

* No responsibility can be accepted by Saunders Havill Group Pty Ltd., for any damage caused to any underground service or any loss or injury so suffered if enquiry and verification have not been completed in accordance with this note.

** This note is an integral part of this plan/data. Reproduction of this plan or any part of it without this note being included in full will render the information shown on such reproduction invalid and not suitable for use.



ISSUES		DATE	DESCRIPTION
A	TG	11.12.2025	ORIGINAL ISSUE
B	TG	25.02.2026	DRAINAGE ADDED

LOT DESCRIPTION
LOTS 1101-1167 ON SP344921

LOCALITY:
WORONGARY

LOCAL GOVERNMENT:
CITY OF GOLD COAST

SURVEYED	DATE
MA	Oct-Nov, 2025

CLIENT
CRA GROUP PTY LTD

PROJECT
SKYRIDGE - STAGE 11


LEVEL DATUM:
AHD Der.

ORIGIN OF LEVELS:
PM72575

RL OF ORIGIN:
10.664

CONTOUR INTERVAL:
-

SCALE
1:250@A1
1:500@A3

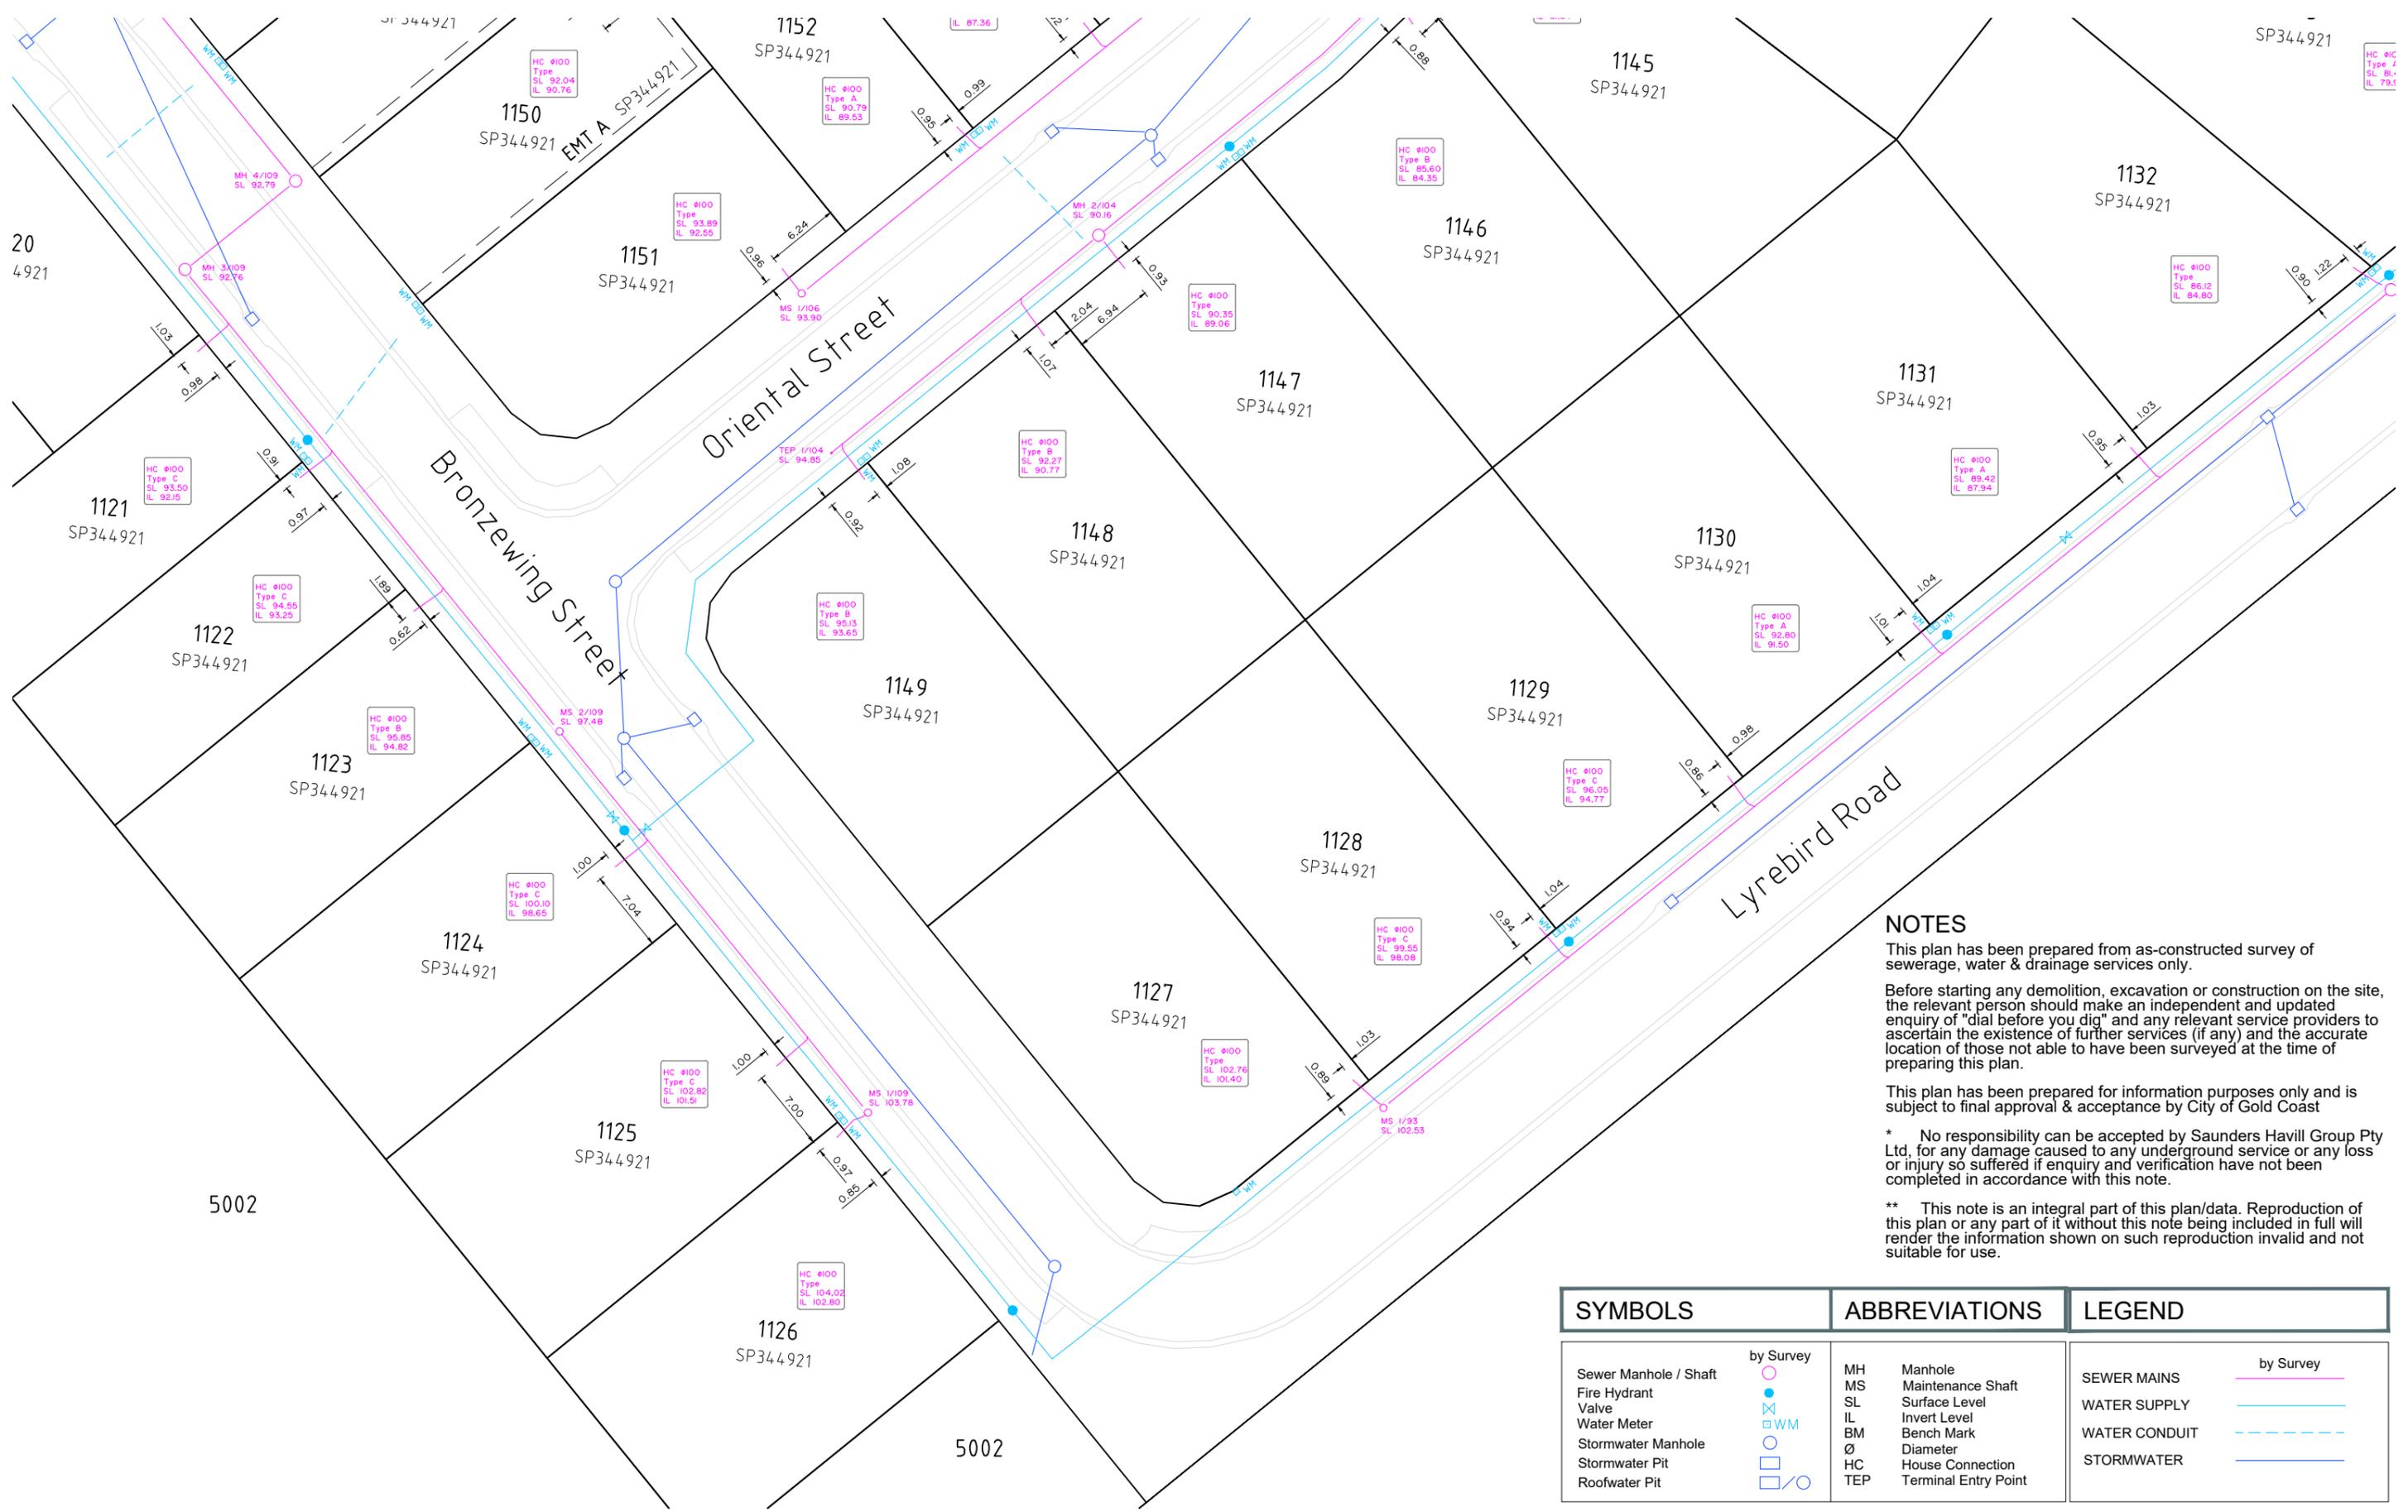

NOTES

This plan has been prepared from as-constructed survey of sewerage, water & drainage services only.

Before starting any demolition, excavation or construction on the site, the relevant person should make an independent and updated enquiry of "dial before you dig" and any relevant service providers to ascertain the existence of further services (if any) and the accurate location of those not able to have been surveyed at the time of preparing this plan.

This plan has been prepared for information purposes only and is subject to final approval & acceptance by City of Gold Coast

* No responsibility can be accepted by Saunders Havill Group Pty Ltd, for any damage caused to any underground service or any loss or injury so suffered if enquiry and verification have not been completed in accordance with this note.

** This note is an integral part of this plan/data. Reproduction of this plan or any part of it without this note being included in full will render the information shown on such reproduction invalid and not suitable for use.

SYMBOLS		ABBREVIATIONS	LEGEND
Sewer Manhole / Shaft	○	MH	Manhole
Fire Hydrant	●	MS	Maintenance Shaft
Valve	⊗	SL	Surface Level
Water Meter	⊠	IL	Invert Level
Stormwater Manhole	○	BM	Bench Mark
Stormwater Pit	○	∅	Diameter
Roofwater Pit	○	HC	House Connection
		TEP	Terminal Entry Point
	by Survey		
	○		SEWER MAINS
	●		WATER SUPPLY
	⊠		WATER CONDUIT
	○		STORMWATER
	○		by Survey



ISSUES			
NO.	DRAWN	DATE	DESCRIPTION
A	TG	11.12.2025	ORIGINAL ISSUE
B	TG	25.02.2026	DRAINAGE ADDED

LOT DESCRIPTION
 LOTS 1101-1167 ON SP344921

LOCALITY:
 WORONGARY
 LOCAL GOVERNMENT:
 CITY OF GOLD COAST

SURVEYED
 MA

DATE
 Oct-Nov, 2025


CLIENT
 CRA GROUP PTY LTD

LEVEL DATUM:
 AHD Der.

ORIGIN OF LEVELS:
 PM72575

RL OF ORIGIN:
 10.664

CONTOUR INTERVAL:
 -

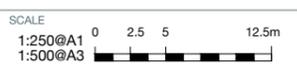

PROJECT
 SKYRIDGE - STAGE 11